
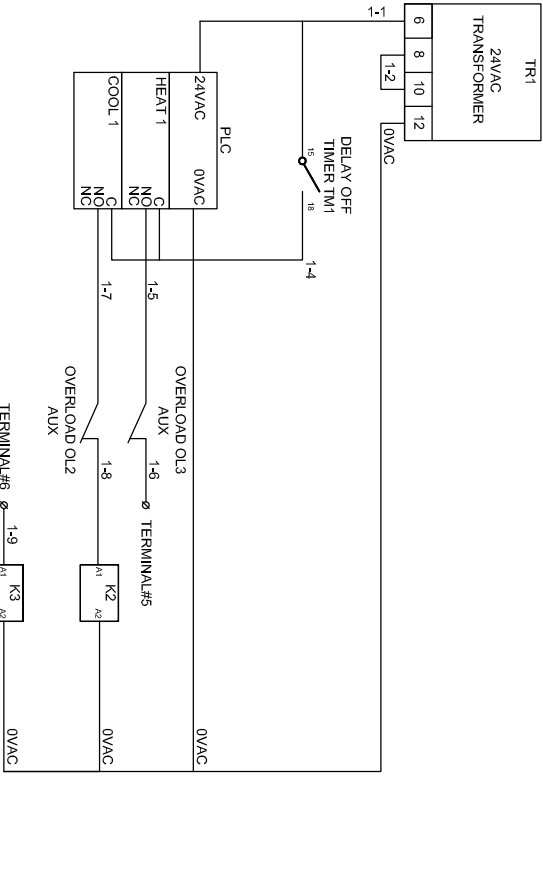


A/C CONTROL PANEL 1

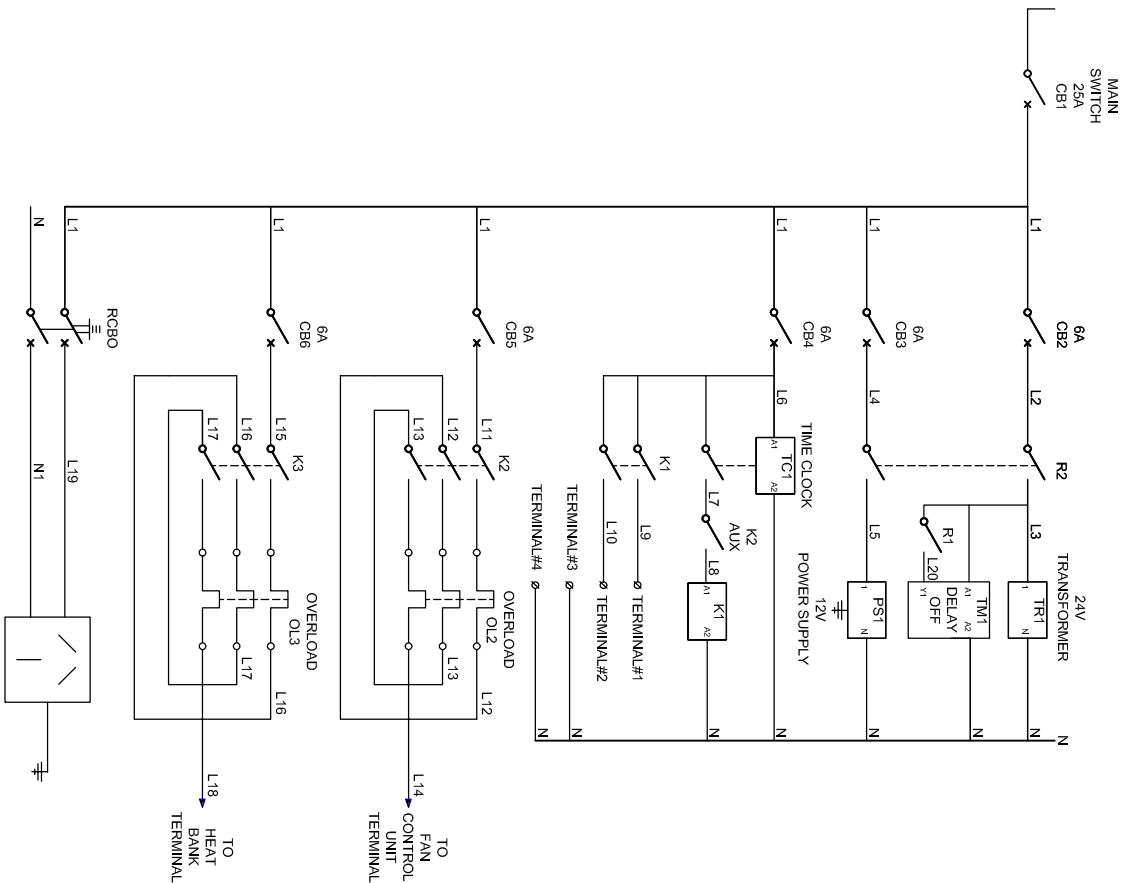

AS CONSTRUCTED DRAWING

C		DESIGNED		PROJECT MGR	
B		ANDREW FLACK		CAMERON MCGRACKEN	
A		DRAWN		APPROVED	
REV		DATE		DATE	
1		16/07/12		16/07/12	
2		16/07/12		16/07/12	
3		16/07/12		16/07/12	
4		16/07/12		16/07/12	
5		16/07/12		16/07/12	
6		16/07/12		16/07/12	
7		16/07/12		16/07/12	
8		16/07/12		16/07/12	
9		16/07/12		16/07/12	
10		16/07/12		16/07/12	
11		16/07/12		16/07/12	
12		16/07/12		16/07/12	

AS BUILT

16/07/12

DATE

DESCRIPTION

16/07/12

DATE

www.12electrical.com.au

www.12electrical.com.au

POWER TO YOU

www.12electrical.com.au

Dept. Primary Industries

LEVEL 3, 80 ANN STREET, BRISBANE CBD, 4000

WIRING DIAGRAM, A/C CONTROL PANEL 1

DO NOT SCALE

SCALE: NTS

DRAWING NUMBER S100747_1

SHEET 1 OF 1

REV A

REV A